




REVISION	DATE	COMMENTS
1.	2/15/18	ADDENDUM 4H
2.	4/16/18	BULLETIN 1H
3.	7/3/18	BULLETIN 9H

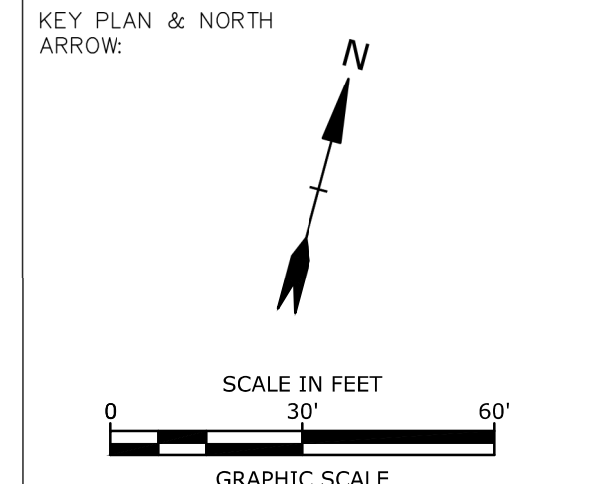


PROJECT:  
**NEWMARKET JUNIOR/  
SENIOR HIGH SCHOOL**  
213 S MAIN STREET  
NEWMARKET, NH 03857

ISSUED:  
BIDDING DOCUMENTS

DRAWING TITLE:  
**GRADING, DRAINAGE, &  
EROSION CONTROL PLAN**

PROJECT NO: 15-340 DATE: 1/12/2018

SHEET NUMBER:  
**C105H**

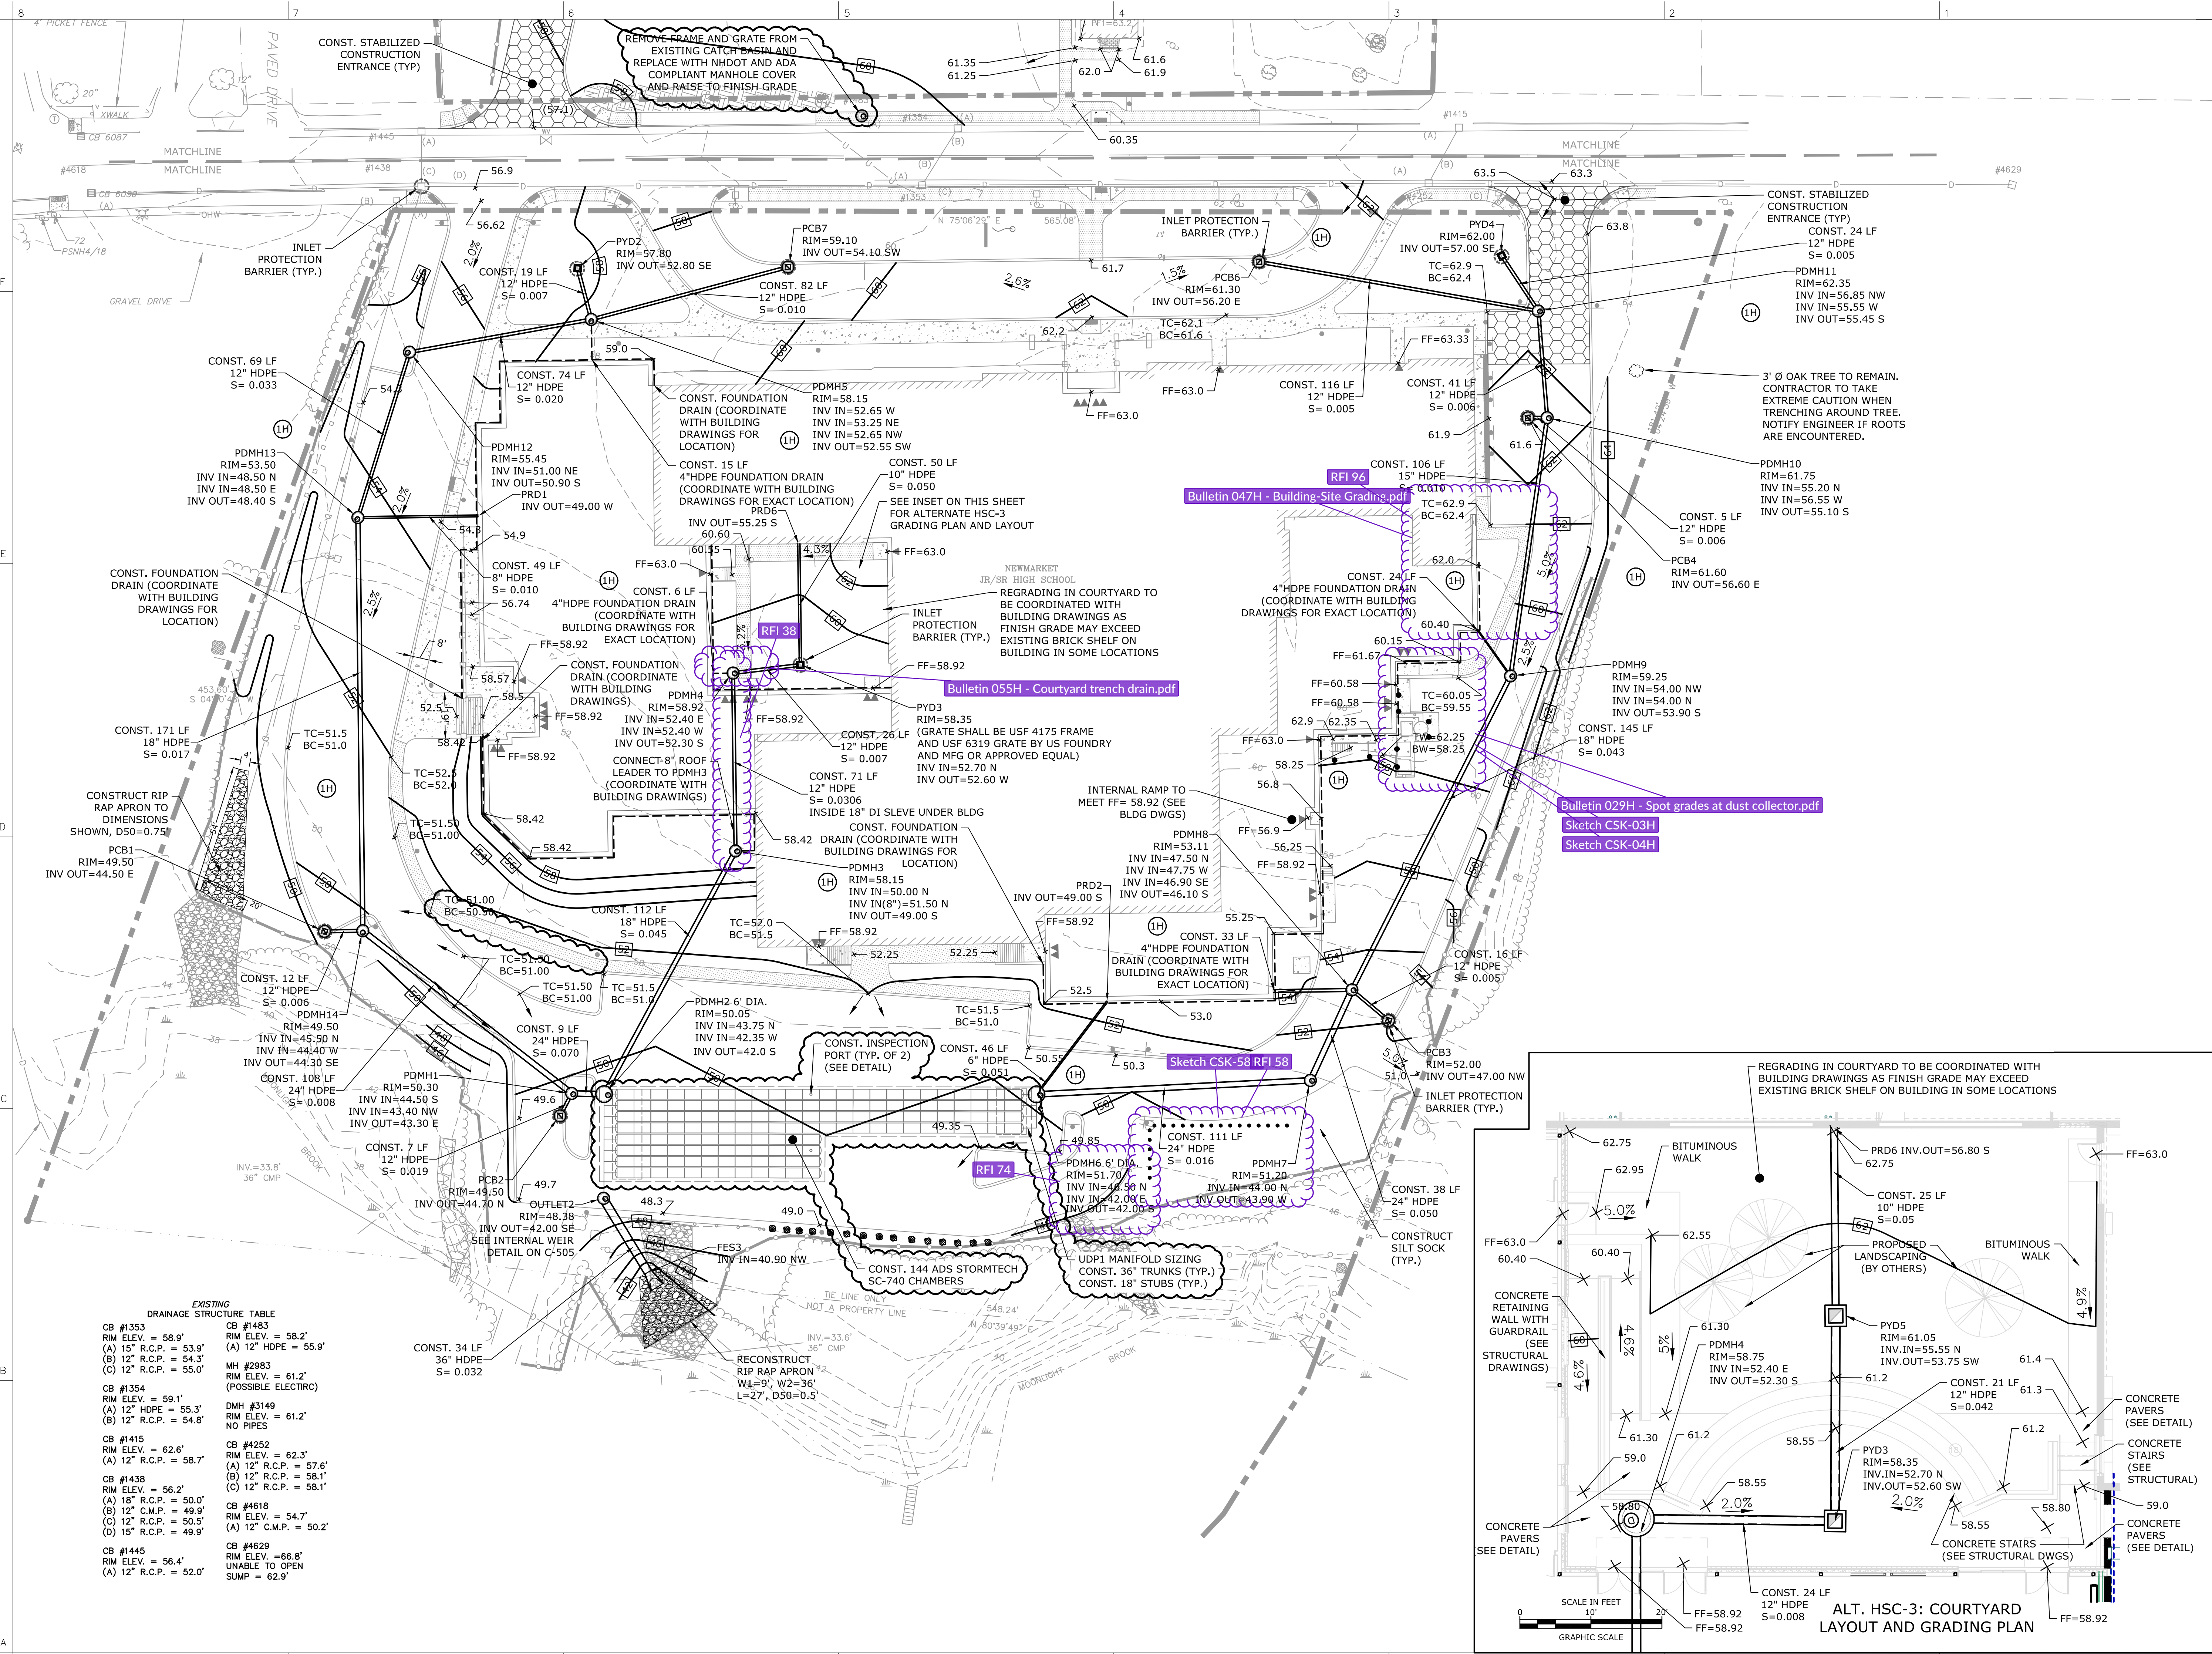

Last Save Date: July 3, 2018, 4:10 PM By: BCLARK  
 Plot Date: Tuesday, July 03, 2018 Plotted By: Benjamin Clark  
 Tab File Location: J:\S2261 SAU 31 Newmarket, NH Drawings - Figures\AutoCAD\Newmarket High School\Sheet\2261-C-HS-GRAD.dwg Layout Tab: C-105